Received **Planning Division** 01/29/2024

## **DEMOLITION NOTES**

- A. THE EXISTING CONDITIONS SHOWN WERE TAKEN FROM AVAILABLE RECORD INFORMATION. FIELD VERIFY ALL CONDITIONS THAT MAY AFFECT CONSTRUCTION. IF ANY DISCREPANCIES ARE DISCOVERED, NOTIFY THE ENGINEER IN WRITING AND REQUEST DIRECTION PRIOR TO COMMENCING WORK.
- B. EXISTING LIGHT FIXTURES SHALL BE CAREFULLY REMOVED (DO NOT DAMAGE) AND RETURNED TO THE OWNER.
- C. ANY AND ALL EQUIPMENT HAVING ELECTRICAL CONNECTIONS THAT REQUIRE DISCONNECTING AND/OR RE-CONNECTING AS A RESULT OF CONSTRUCTION SHALL BE INCLUDED AS A PART OF THIS CONTRACT.
- D. THE EXISTING ELECTRICAL DEVICES, CONDUIT, AND/OR EQUIPMENT THAT FOR ANY REASON OBSTRUCTS CONSTRUCTION SHALL BE RELOCATED UNLESS OTHERWISE NOTED. LOCATION IS TO BE AS CLOSE AS POSSIBLE TO THE ORIGINAL LOCATION.
- E. ALL CIRCUITS, CONDUIT AND WIRE THAT ARE NOT TO REMAIN IN SERVICE SHALL BE REMOVED BACK TO THE FIRST ACCESSIBLE JUNCTION BOX WHERE IT SHALL BE TIED OFF AND LABELED AS SPARE WITH CIRCUIT NUMBER INDICATED.
- F. REMOVE ALL ABANDONED WIRE AND CABLING.

## **GENERAL NOTES**

- 1. SYMBOLS LEGENDS ARE PROVIDED FOR REFERENCE PURPOSES ONLY. THE SYMBOLS REPRESENT THE TYPE OF DEVICES THAT MAY BE REQUIRED IN THE WORK; QUANTITIES AND LOCATIONS ARE AS SHOWN ON THE PLAN
- 2. PROVIDE 3/4" CONDUIT & #12 CONDUCTORS UNLESS NOTED OTHERWISE. PROVIDE ONE NEUTRAL CONDUCTOR FOR EACH UNGROUNDED CONDUCTOR OF SINGLE PHASE LINE-NEUTRAL BRANCH CIRCUITS. DO NOT SHARE NEUTRAL CONDUCTORS.
- 3. EACH FEEDER AND BRANCH CIRCUIT CONDUIT SHALL HAVE AN EQUIPMENT GROUNDING CONDUCTOR SIZED IN ACCORDANCE WITH NFPA 70, ARTICLE 250.
- 4. ALL ELECTRICAL EQUIPMENT IN PORTIONS OF THE BUILDING NOT BEING REMODELED SHALL BE LEFT IN WORKING CONDITION. RESTORE ANY CIRCUITS INTERRUPTED.
- 5. ALL NEW LIGHT FIXTURES AND FIXTURES IN AREAS ADJACENT DEMOLITION & CONSTRUCTION AREAS ARE TO BE THOROUGHLY CLEANED IMMEDIATELY PRIOR TO NOTICE OF SUBSTANTIAL COMPLETION.

6. THE FOLLOWING IS PART OF THIS PROJECT AND ALL COSTS PERTAINING THERETO SHALL BE INCLUDED IN THE

- BASE BID:
- A. NEW ELECTRICAL EQUIPMENT AND APPARATUS SHALL BE COORDINATED AND CONNECTED INTO THE EXISTING SYSTEM AS REQUIRED.
- B. POWER WIRING AND CABLE INSTALLATIONS SHALL BE CONCEALED ABOVE ACCESSIBLE CEILINGS AND IN WALLS. EXPOSED WIRING SHALL BE INSTALLED IN APPROVED SURFACE METAL RACEWAY WHERE
- C. WHERE EXISTING CONDUITS ARE INDICATED FOR REUSE, FIELD VERIFY INTEGRITY OF REUSED RACEWAYS PRIOR TO INSTALLATION OF CONDUCTORS. PROVIDE NEW RACEWAYS WHERE EXISTING ARE UNUSABLE.
- D. LOCATIONS OF ALL WALL MOUNTED DEVICES SUCH AS SWITCHES, RECEPTACLES, AND OUTLETS ARE SHOWN DIAGRAMMATICALLY. DETERMINE EXACT DEVICE LOCATIONS IN FIELD; COORDINATE INSTALLATIONS WITH FIXED CASEWORK, DOORS AND RELITES.
- E. PROVIDE PENETRATIONS THROUGH WALLS, FLOORS, AND CEILINGS AS REQUIRED. PROVIDE SUITABLE FIRE RATED MATERIALS AND SEAL ALL CEILING, FLOOR, AND WALL PENETRATIONS TO MATCH FIRE RATING

### LIGHTING AND RECEPTACLE NOTES

- 1. LIGHTING SYSTEMS SHALL BE PROVIDED WITH CONTROLS AS ZONED ON THE LIGHTING PLANS. SWITCHING AND DIMMING ZONES ARE INDICATED ADJACENT TO EACH FIXTURE.
- 2. MANUAL CONTROLS SHALL ALLOW OCCUPANTS TO UNIFORMLY REDUCE ILLUMINATION LEVELS AT LEAST 50%. EXCEPTION: CORRIDORS, RESTROOMS, LOBBIES, MECHANICAL, ELECTRICAL, AND INFORMATION TECHNOLOGY (IDF) ROOMS CONTROLLED BY OCCUPANCY SENSORS.
- 3. EACH AREA THAT IS REQUIRED TO HAVE A MANUAL CONTROL SHALL ALSO HAVE AUTOMATIC TIME SWITCH CONTROL. PROVIDE TIMED OVERRIDE SWITCHES THAT WILL SERVE A MAXIMUM AREA OF 2500 SF IN LOCATIONS SHOWN ON PLANS. EXCEPTIONS:
- A. EMERGENCY EGRESS LIGHTING CONTROLLED BY OCCUPANCY SENSORS. B. LIGHTING IN SPACES CONTROLLED BY OCCUPANCY SENSORS.
- 4. LUMINAIRES PROVIDING MEANS OF EGRESS ILLUMINATION AND HAVING BOTH NORMAL AND EMERGENCY POWER SOURCES SHALL BE CONTROLLED BY A COMBINATION OF U.L. 924 LISTED EMERGENCY RELAYS AND OCCUPANCY SENSORS THAT ENABLES THE LIGHTING TO BE SHUT OFF WHEN THE AREAS SERVED ARE UNOCCUPIED AND AUTOMATICALLY ILLUMINATES IN THE EVENT OF NORMAL POWER SOURCE FAILURE
- 5. THE MAXIMUM LIGHTING POWER THAT MAY BE CONTROLLED FROM A SINGLE SWITCH OR AUTOMATIC CONTROL SHALL NOT EXCEED THAT WHICH IS PROVIDED BY A 20 AMPERE CIRCUIT LOADED TO NOT MORE THAN 80
- 6. PROVIDE FUNCTIONAL TESTING OF AUTOMATIC LIGHTING CONTROLS. SUBMIT WRITTEN PROCEDURES FOR FUNCTIONAL TESTING OF ALL AUTOMATIC CONTROLS WITH DESCRIPTION OF THE EXPECTED SYSTEM

## STRUCTURED CABLE SYSTEM PATHWAY NOTES

- 1. SYSTEM CABLING PATHWAYS SHALL BE INSTALLED IN ACCORDANCE WITH THE MOST CURRENT VERSION OF
- 2. CABLE SUPPORTS SHALL NOT BE PLACED MORE THAT 5' APART.
- 3. CABLE "SAG" BETWEEN SUPPORTS SHALL NOT EXCEED 12".
- 4. CABLE LENGTHS SHALL NOT EXCEED 295', INCLUDING PATCH CORD LENGTHS AT COMM ROOMS AND WORKSTATIONS. IF A CABLE LENGTH WILL EXCEED 295', INFORM THE ICT ENGINEER IMMEDIATELY BEFORE INSTALLATION.
- 5. CABLE MINIMUM BEND RADIUS AND MAXIMUM PULLING TENSION SHALL NOT BE EXCEED. REFER TO MANUFACTURER'S REQUIREMENTS AND REFERENCE DOCUMENTS.
- 6. CABLES SHALL BE INSTALLED IN CONTINUOUS LENGTHS FROM ORIGIN TO DESTINATION (NO SPLICES).
- 7. CABLES SHALL BE INSTALLED ABOVE FIRE-SPRINKLER SYSTEMS AND SUPPORTED INDEPENDENTLY OF SPRINKLER PIPING OR ANY ANCILLARY EQUIPMENT OR HARDWARE. THE CABLE SYSTEM AND SUPPORT HARDWARE SHALL BE INSTALLED SO THAT IT DOES NOT OBSCURE ANY VALVES, FIRE ALARM CONDUIT, BOXES, OR OTHER CONTROLLED DEVICES.
- 8. CABLES SHALL NOT BE ATTACHED TO CEILING GRID OR LIGHTING FIXTURE WIRES.
- 9. AT NO POINT SHALL CABLES REST ON ACOUSTIC CEILING GRIDS OR PANELS, OR BE ATTACHED TO ANY PORTION OF THE BUILDING MECHANICAL OR PIPING SYSTEMS. PROVIDE COMPLETE CABLE SUPPORT PATHWAYS CONSISTING OF CONDUIT, RACEWAY, LADDER RACK, CABLE TRAY, J-HOOKS OR BRIDAL RINGS.
- 10. ANY CABLE DAMAGED DURING INSTALLATION OR EXCEEDING RECOMMENDED INSTALLATION PARAMETERS SHALL BE REPLACED PRIOR TO FINAL ACCEPTANCE AT NO ADDITIONAL COST TO THE OWNER.
- 11. CABLES AND PATHWAYS SHALL BE CLEARLY LABELED IN ACCORDANCE WITH TIA-606-C.
- 12. PROVIDE "VELCRO" TYPE (HOOK AND LOOP) TIE WRAPS FOR BUNDLING / MANAGING HORIZONTAL AND BACKBONE CABLING, PLACE EVERY 5' FOR CABLE RUNS IN CEILING AND EVERY 18" AFTER ENTERING TELECOMMUNICATIONS ROOM. PLASTIC "ZIP-TIES" SHALL NOT BE PERMITTED WITHIN THE STRUCTURED CABLING
- 13. HORIZONTAL UTP PAIR UNTWIST AT THE TERMINATION SHALL NOT EXCEED 0.5".
- 14. PROVIDE (1) 2" CONDUIT SLEEVE WITH INSULATED BUSHINGS FOR PENETRATION INTO OFFICES, EXAM ROOMS. ETC, AS REQUIRED TO FACILITATE CABLE ROUTING WHETHER SHOWN ON DRAWINGS OR NOT.
- 15. ALL PENETRATIONS MUST BE FIRE-STOPPED IN ACCORDANCE OF THE NFPA, NEC AND TO THE SATISFACTION OF THE AHJ.
- 16. ALL TELECOMMUNICATION ROOMS AND PATHWAYS SHALL ADHERE TO TIA-569-D.
- 17. ALL TELECOMMUNICATION BONDING AND GROUNDING SHALL ADHERE TO TIA-607-D.
- 18. NOT ALL PARTS SHOWN. ENSURE A COMPLETE WORKING INSTALLATION INCLUDING MISCELLANEOUS INSTALLATION MATERIALS, CONNECTORS, CONSUMABLES, AND APPURTENANCES.
- 19. PROVIDE NETWORK/TELEPHONY CABLES TO THE FOLLOWING LOCATIONS FROM THE NEAREST COMMUNICATIONS ROOM, UNLESS OTHERWISE NOTED:
- A. ELEVATOR CONTROL PANELS/ENCLOSURES
- B. BUILDING SYSTEM MANAGEMENT PANELS/ENCLOSURES
- C. ENERGY SYSTEM MANAGEMENT PANELS/ENCLOSURES
- D. FIRE ALARM CONTROL SYSTEM PANELS/ENCLOSURES
- E. ACCESS CONTROL SYSTEM PANELS/ENCLOSURES
- F. TWO-WAY EMERGENCY COMMUNICATIONS SYSTEMS PANELS/ENCLOSURES

ABBRI	EVIATIONS		Exhibit 3.15
	AT	MAG	MAGNETIC
@ A/C	AIR CONDITIONING(ER)	MAN	MANUAL
A (AMP) AC	AMPERE ABOVE COUNTER, ALTERNATING	MAT MAX	MATERIAL MAXIMUM
45.	CURRENT	MCA	MINIMUM CIRCUIT AMPACITY
ADJ ADJT	ADJUSTABLE ADJACENT	MCB MECH	MAIN CIRCUIT BREAKER MECHANICAL
AFF	ABOVE FINISHED FLOOR	MEZZ	MEZZANINE
AHJ AIC	AUTHORITY HAVING JURISDICTION AMPERE INTERRUPTING CAPACITY	MG MIN	MOTOR GENERATOR MINIMUM
ALT	ALTERNATE	MISC	MISCELLANEOUS
ANN ARCH	ANNUNCIATOR ARCHITECT; ARCHITECTURAL	MLO MOCP	MAIN LUG ONLY MAXIMUM OVERCURRENT
ATS	AUTOMATIC TRANSFER SWITCH	WOOF	PROTECTION
AUTO AUX	AUTOMATIC AUXILIARY	MS MTD	MAGNETIC STARTER MOUNTED
AWG	AMERICAN WIRE GAUGE	MTG	MOUNTING
BKBD	DACKBOARD	MTR	MOTOR
BKR	BACKBOARD BREAKER	N	NORTH; NEUTRAL
BLDG	BUILDING	N/A NC	NOT APPLICABLE
С	CONDUIT	NEC	NORMALLY CLOSED  NATIONAL ELECTRICAL CODE
CAP	CAPACITY	NEMA	NATIONAL ELECTRICAL
CB CKT	CIRCUIT BREAKER CIRCUIT	NESC	MANUFACTURERS ASSOCIATION NATIONAL ELECTRICAL SAFETY CODE
CLG	CEILING	NEUT	NEUTRAL
CLR COL	CLEAR COLUMN	NFPA NIC	NATIONAL FIRE PROTECTION ASSOC. NOT IN CONTRACT
COM	COMMUNICATION	NO	NORMALLY OPEN
CPS CT	CYCLES PER SECOND CURRENT TRANSFORMER	NTS	NOT TO SCALE
CTL	CONTROL	OC	ON CENTER
CU	COPPER	OFCI	OWNER FURNISHED CONTRACTOR INSTALLED
DC	DIRECT CURRENT	OFOI	OWNER FURNISHED OWNER
DISC SW DISC	DISCONNECT SWITCH DISCONNECT	OL OS	INSTALLED OVERLOAD OPTIONAL STANDBY
DN	DOWN		
DWG	DRAWING	P PA	PRIMARY PUBLIC ADDRESS
E	EXIST, EAST	PAR	PARALLEL
EDH EF	ELECTRIC DUCT HEATER EXHAUST FAN	PB PE	PULL BOX PHOTO ELECTRIC
EGC	EQUIPMENT GROUNDING CONDUCTOR	PF	POWER FACTOR
EL ELEC	ELEVATION ELECTRIC(AL)	PH PIV	PHASE POST INDICATOR VALVE
ELEV	ELECTRIC(AL) ELEVATOR	PNL	PANEL
EM	EMERGENCY	POC	POINT OF CONNECTION
EMT ENCL	ELECTRICAL METALLIC TUBING ENCLOSURE	PWR	POWER
ENTR	ENTRANCE EVALUATION PROOF	QTY	QUANTITY
EP EPO	EXPLOSION PROOF EMERGENCY POWER OFF	R (R)	RELOCATE (D)
EQUIP/EQP		RAD	RADIUS
EWC EWH	ELECTRIC WATER COOLER ELECTRIC WATER HEATER	RECPT REF	RECEPTACLE REFRIGERATOR
EXH	EXHAUST	RLA	RATED LOAD AMPS
EXT EXIST	EXTERIOR EXISTING	RPM	REVOLUTIONS PER MINUTE
_	FALIDENIJEIT/EUGE	S	SOUTH
F FA	FAHRENHEIT/FUSE FIRE ALARM	SC SD	SECURITY SMOKE DETECTOR
FAA	FIRE ALARM ANNUNCIATOR	SECT	SECTION
FAP FC	FIRE ALARM PANEL FOOTCANDLE	SF SHT	SUPPLY FAN SHEET
FCU	FAN COIL UNIT	SPEC	SPECIFICATION
FD FDR	FIRE DAMPER FEEDER	SPL SQ	SPECIAL SQUARE
FIXT	FIXTURE	STOR	STORAGE
FLA FSD	FULL LOAD AMPS FIRE/SMOKE DAMPER	SPD SW	SURGE PROTECTION DEVICE SWITCH
		SWBD	SWITCHBOARD
GEC GEN	GROUNDING ELECTRODE CONDUCTOR GENERATOR	SYM SYS	SYMMETRICAL SYSTEM
GFI	GROUND FAULT CIRCUIT INTERRUPTER		
GFR	GROUND FAULT RELAY	T TB	THERMOSTAT TERMINAL BOX
Н	HEIGHT	TC	TIME CLOCK
HOA HOR	HAND OFF AUTOMATIC HORIZONTAL	TEL TV	TELEPHONE TELEVISION
HP	HORSEPOWER	TYP	TYPICAL
HR HT	HOUR HEIGHT	UFC	UNIFORM FIRE CODE
HW	HOT WATER	UG	UNDERGROUND
HZ	HERTZ	UH UL	UNIT HEATER UNDERWRITERS LABORATORIES
IBC	INTERNATIONAL BUILDING CODE	UON	UNLESS OTHERWISE NOTED
IC IES	INTERCOM ILLUMINATING ENGINEERING SOCIETY	UV	UNIT VENTILATOR
IEEE IEEE	INSTITUTE OF ELECTRICAL AND ELECTRONIC	V	VOLT
	ENGINEERS	VAV	VARIABLE AIR VOLUME
IG IMC	ISOLATED GROUND INTERMEDIATE METAL CONDUIT	VEL VM	VELOCITY VOLTMETER
IN	INCH	VOL	VOLUME
JB	JUNCTION BOX	W	WATT, WEST
		W/	WITH
KCMIL KVA	THOUSAND CIRCULAR MILLS KILOVOLT AMPERES	W/O WH	WITHOUT WATER HEATER
KVAR	KILOVOLT AMPERES REACTIVE	WHM	WATTHOUR METER
KW KWH	KILOWATT KILOWATT HOUR	WP	WEATHERPROOF
		Χ	REACTANCE
LBS LF	POUNDS LINEAR FEET (FEET)	XFMR XMTR	TRANSFORMER TRANSMITTER

LINEAR FEET (FEET)

LIFE SAFETY

LIGHTING LOW VOLTAGE

LTG

LOCKED ROTOR AMPS

TRANSMITTER

IMPEDANCE

THAT IS

# **ELECTRICAL SHEET INDEX**

E0.00 GENERAL NOTES, ABBREVIATIONS AND SHEET INDEX E0.01 ELECTRICAL LEGEND E1.01 SITE PHOTOMETRIC PLAN - PHASE 1 E1.02 SITE PHOTOMETRIC PLAN - PHASE 2



Baysinger Partners Architecture 2410 N. Lombard Street Portland, OR 97217 503-546-1600 MattL@Baysinger.Partners



Well-crafted simplicity.



111 SW Fifth Ave, Ste 3210 Portland, Oregon 97204



**PETERKORT** MANAGEMENT CO.

**TOWN SQUARE ROCK GYM** 

PK 21056

07.01.2022


Author / Checker


Original Issue: Drawn/Checked By: © 2022 Baysinger Partners Architecture

**GENERAL** NOTES, **ABBREVIATIONS** AND SHEET **INDEX** 

E0.00


**DESIGN REVIEW** 

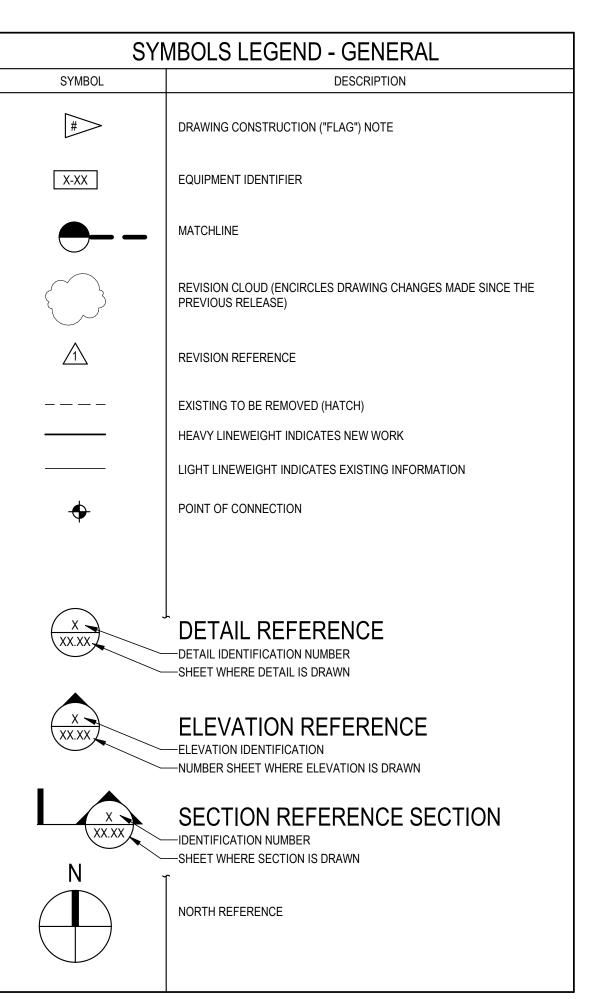


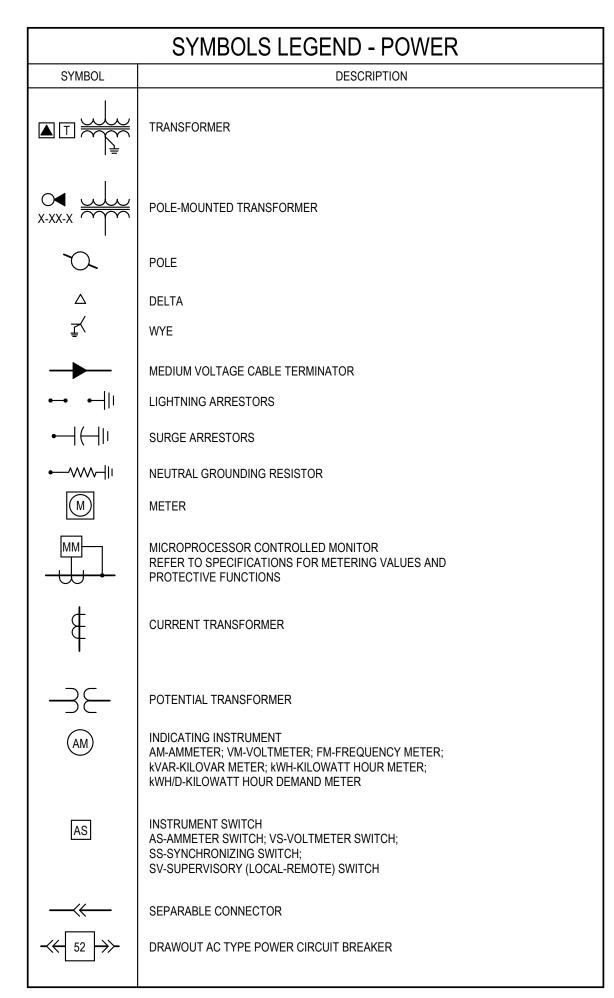

	SYMBOLS LEGEND - POWER										
SYMBOL	DESCRIPTION										
CB o	CIRCUIT BREAKER ST - INDICATES SHUNT TRIP										
CB xxxA/xP	ENCLOSED CIRCUIT BREAKER (PLAN VIEW) xxxA/xP - AMPS/POLES										
°)	ENCLOSED CIRCUIT BREAKER (ONE-LINE DIAGRAM) xxxA/xP - AMPS/POLES										
	BREAKER WITH EXTERNAL GROUND FAULT RELAY AND CT										
, , )	CIRCUIT BREAKER WITH INTEGRAL GROUND FAULT PROTECTION										
δ γ	MOTOR-OPERATED CIRCUIT BREAKER										
	SWITCH WITH EXTERNAL GROUND FAULT RELAY AND CT										
<u>—</u>	MOV SURGE PROTECTION										
<b>—</b>	RESISTOR										
	FUSE										
<u></u>	MOTOR THERMAL OVERLOADS - (3) UNLESS OTHERWISE NOTED										
	NORMALLY OPEN CONTACT										
<del> </del>	NORMALLY CLOSED CONTACT										
(SV) -0/0-	SOLENOID VALVE										
M	MOTOR-OPERATED VALVE										
T	THERMOSTAT										
••••••••••••••••••••••••••••••••••••••	TERMINAL BLOCK										
	INDICATING LIGHT - TYPE AS NOTED A-AMBER; B-BLUE; G-GREEN; R-RED; W-WHITE BATTERY										

SYMBOL	DESCRIPTION								
	2 DOCITION OF LECTOR CHARGO								
~ \ \ \ \	2-POSITION SELECTOR SWITCH								
* <u>\</u>	3-POSITION SELECTOR SWITCH HAND-OFF-AUTOMATIC								
o-'-ok									
	ON-OFF SELECTOR SWITCH								
<u> </u>	2-CIRCUIT PUSHBUTTON								
	PUSHBUTTON SWITCH MOMENTARY CONTACT								
<u> </u>	PUSHBUTTON SWITCH MOMENTARY CONTACT								
$\otimes$	EQUIPMENT CONNECTION								
(G)	GENERATOR								
(M)	MOTOR CONNECTION								
M)SD	SMOKE DAMPER								
(M) FSD	FIRE SMOKE DAMPER								
$\boxtimes$ —(M)—	STARTER 3-POLE, NEMA SIZE 1 MINIMUM UNLESS NOTED OTHERWISE								
lacktriangle	COMBINATION STARTER								
⊠ı	HP RATED, 3-POLE, NEMA SIZE 1 MINIMUM, UNLESS NOTED								
	OTHERWISE - OVERCURRENT PROTECTION AS REQUIRED BY EQUIPMENT MANUFACTURER OR AS NOTED								
_ <									
□ ~ ~	DISCONNECT SWITCH								
	3-POLE UNLESS NOTED OTHERWISE								
	FUSED DISCONNECT SWITCH								
	3-POLE UNLESS NOTED OTHERWISE								
	CONTACTOR								
<b></b> ¦├									
	RELAY COIL CR-CONTROL RELAY; TD-TIME DELAY RELAY;								
(CR)	UV-UNDERVOLTAGE RELAY; M-MOTOR								
	CONTACTOR;								
\$ <sup>M</sup>	MOTOR-RATED SWITCH - SIZE OL PER MOTOR REQUIREMENTS								
<b>⊢</b>	EQUIPMENT EMERGENCY SHUTDOWN SWITCH								
• •									

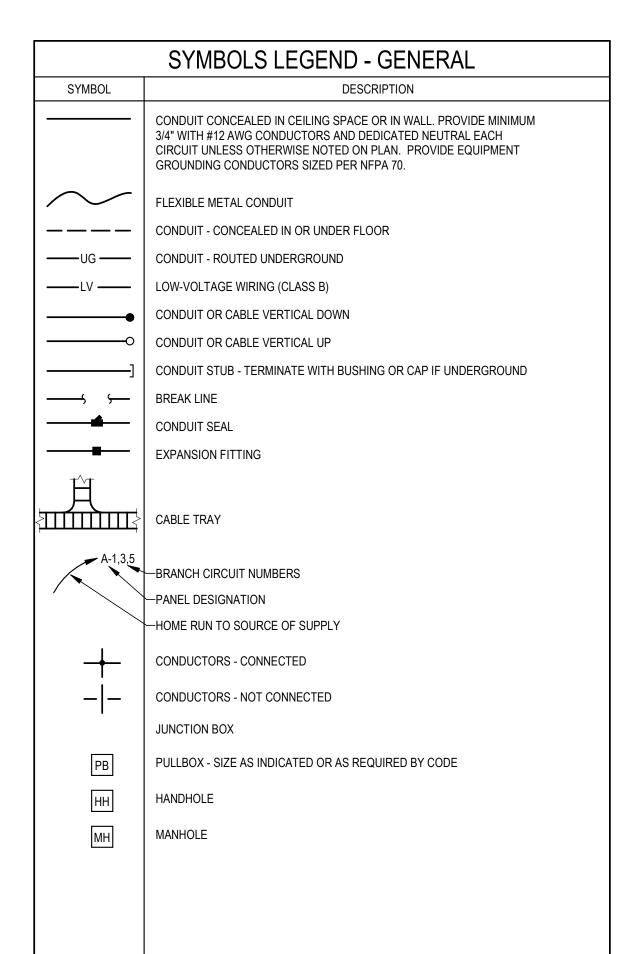


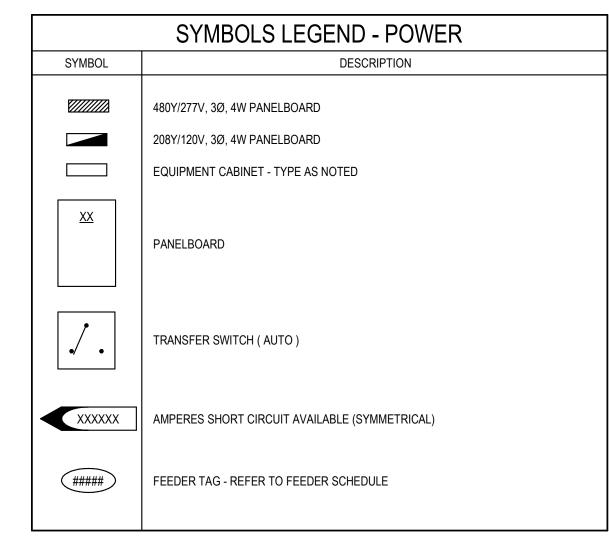

SYMBOLS LEGEND - GROUNDING									
SYMBOL	DESCRIPTION								
<u></u>	GROUND CONNECTION								
<b>-</b> -  ।	GROUND ROD								
$\bigcirc \exists l$	GROUND WELL								
$+\odot$	AIR TERMINAL								

SYMB	OL	DESCRIPTION
\$		SINGLE-POLE WALL SWITCH MOUNT SWITCHES AT 48" AFF. TO TOP, UON.
\$'	кх	WALL SWITCH - SUBSCRIPT
		2 = 2-POLE LV = LOW-VOLTAGE 3 = 3-WAY OS = OCCUPANCY SENSOR TYPE 4 = 4-WAY OP = OCCUPANCY/PHOTOELECTRIC TYPE K = KEYED WP = WEATHERPROOF LOWER CASE LETTER INDICATES SWITCHING GROUP
		MOUNT SWITCHES AT +48" AFF. TO TOP, UON. ANY COMBINATION OF SWITCH TYPES CAN BE USED (IE. 3K = 3-WAY KEYED SWITCH)
$\Diamond$	1	SPECIAL PURPOSE RECEPTACLE TYPE AS SHOWN ON PLANS
耳	€	SINGLE SERVICE OR COMBINATION FLUSH MOUNTED FLOOR BOX. REFER TO FLOOR PLANS FOR DEVICES.
	€	SINGLE SERVICE OR COMBINATION FLUSH FLOOR POKE THRU. REFER TO FLOOR PLANS FOR DEVICES.
		POWER/COMM POLE - FLOOR TO CEILING. SURFACE MOUNTED FLOOR BOX (PEDESTAL TYPE). PUSH BUTTON
Ф		SIMPLEX RECEPTACLE NEMA 5-20R, +18" AFF UON
$\rightleftharpoons$	<b>⊕</b>	NEMA 5-20R, +18" AFF UON
<b>⊕</b> T	⊕т	TAMPER RESISTANT, NEMA 5-20R, +18" AFF UON
⊖s	<b>⊕</b> s	SWITCHED RECEPTACLE, NEMA 5-20R, +18" AFF UON
<b>⊟</b> IG	∰lG	ISOLATED GROUND, NEMA 5-20R, +18" AFF UON
$\bigcirc$	<b>••</b>	NEMA 5-20R W/ GROUND FAULT CIRCUIT INTERRUPTER, +18" AFF UON
$\ominus$	<b>₩</b>	SPLIT WIRED, NEMA 5-20R, +18" AFF UON
=	<del></del>	CONTROLLED, NEMA 5-20R, +18" AFF UON
€	<b>(</b>	NEMA 5-20R, ABOVE COUNTER. COORDINATE WITH CASEWORK SHOP DRAWINGS AND ARCHITECTURAL DRAWINGS.
	<b>•</b>	NEMA 5-20R WITH GROUND FAULT CIRCUIT INTERRUPTER, ABOVE COUNTER. COORDINATE WITH CASEWORK SHOP DRAWINGS AND ARCHITECTURAL DRAWINGS.
<b>●</b> T	₩Т	TAMPER RESISTANT, NEMA 5-20R WITH GROUND FAULT CIRCUIT INTERRUPTER, ABOVE COUNTER. COORDINATE WITH CASEWORK SHOP DRAWINGS AND ARCHITECTURAL DRAWINGS.
<b>=</b>	<b>\$</b>	NEMA 5-20R, CONNECTED TO EMERGENCY CIRCUIT, +18" AFF UON
<b>Φ</b> =	<b>Φ</b> =	NEMA 5-20R ON EMERGENCY CIRCUIT MOUNTED ABOVE COUNTER. COORDINATE WITH CASEWORK SHOP DRAWINGS AND ARCHITECTURAL DRAWINGS.
Ф	#	CEILING-MOUNTED, NEMA 5-20R
<b>\$</b>	=	NEMA 5-20R WITH USB CHARGER - (2) TYPE A USB PORTS
<b>\$</b>	= Т	TAMPER RESISTANT, NEMA 5-20R WITH USB CHARGER - (2) TYPE A USB PORTS

SYMBOLS LEGEND - WIRING DEVICES

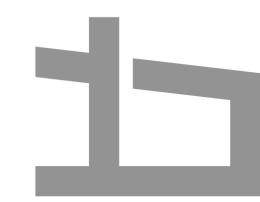

## Baysinge

Baysinger Partners Architecture 2410 N. Lombard Street Portland, OR 97217 503-546-1600 MattL@Baysinger.Partners



Well-crafted simplicity.

SÄZÄN GROUP

111 SW Fifth Ave, Ste 3210 Portland, Oregon 97204



PETERKORT MANAGEMENT CO.

TOWN SQUARE ROCK GYM

Issued / Revise

PK 21056


Original Issue: 07.01.2022
Drawn/Checked By: Author / Checker
© 2022 Baysinger Partners Architecture


ELECTRICAL LEGEND

E0.01

**DESIGN REVIEW** 

	LUMINAIRE SCHEDULE												
FIXTURE TYPE	DESCRIPTION	MOUNTING	CCT / CRI	INPUT WATTS (W)	LUMEN OUTPUT	EFFICACY (LUMENS / WATTS)	BALLAST / TRANSFORMER / DRIVER	VOLTAGE	LENS / REFLECTOR / BEAM	HOUSING	TRIM / FLANGE / BAFFLE / FINISH	MANUFACTURER / CATALOG #	REMARKS / ACCESSORIES/ OPTIONS
01	6'-0" LINEAR LED LUMINAIRE	RECESSED	4000K 80CRI	19	1,660	87	0-10V DIMMING DRIVER	UNV	FLUSH ACRYLIC LENS	ALUMINUM	BY ARCHITECT	ALIGHT - D5 SERIES	PROVIDE PHOTOCELL
O2	TYPE II DISTRIBUTION WALL PACK LED LUMINAIRE	WALL	4000K 70CRI	32	3,215	100	0-10V DIMMING DRIVER	UNV	CLEAR	ALUMINUM	BY ARCHITECT	LITHONIA LIGHTING WDGE2 LED SERIES	WIRELESS CONTROL WITH MOTION SENSOR
О3	TYPE IV DISTRIBUTION WALL PACK LED LUMINAIRE	WALL	4000K 70CRI	185	25862	125	0-10V DIMMING DRIVER	UNV	CLEAR	ALUMINUM	BY ARCHITECT	LITHONIA LIGHTING WDGE4 LED SERIES	WIRELESS CONTROL WITH MOTION SENSOR
04	4'-0" LINEAR LED LUMINAIRE	SURFACE	4000K 80CRI	20	2,274	113	0-10V DIMMING DRIVER	UNV	ACRYLIC LENS	ALUMINUM	BY ARCHITECT	ALIGHT - ALD3ST SERIES	PROVIDE PHOTOCELL
O4C	TYPE IV DISTRIBUTION AREA POST TOP LED LUMINAIRE	12' POLE	4000K 80CRI	99	8500	85	0-10V DIMMING DRIVER	UNV	CLEAR	ALUMINUM	BY ARCHITECT	COOPER LIGHTING - INVUE ARBOR SERIES	WIRELESS CONTROL WITH MOTION SENSOR AND PHOTOCELL
О5	DIRECT VIEW OUTDOOR LED TAPE	SURFACE	4000K 90CRI	5 WATTS PER FOOT	704 LUMENS PER FOOT	140	0-10V DIMMING DRIVER	24V				KELVIX - VIEW 700 (OUTDOOR) SERIES	PROVIDE PHOTOCELL AND ALUMINUM CHANNEL
083	TYPE III DISTRIBUTION AREA POLE LED LUMINAIRE	30' POLE	4000K 80CRI	343	42,341	125	0-10V DIMMING DRIVER	UNV	CLEAR	ALUMINUM	BY ARCHITECT	LITHONIA D SERIES SIZE 2, TYPE 3 DSX2 LED-P8-40K-T3M-MVOLT-RPA-NLTAIR2-PIRH-DNAXD	WIRELESS CONTROL WITH MOTION SENSOR
085	TYPE V DISTRIBUTION AREA POLE LED LUMINAIRE	30' POLE	4000K 80CRI	343	42,349	123	0-10V DIMMING DRIVER	UNV	CLEAR	ALUMINUM	BY ARCHITECT	LITHONIA D SERIES SIZE 2, TYPE 5 DSX2 LED-P6-40K-T5M-MVOLT-RPA-NLTAIR2-PIRH-DNAXD	WIRELESS CONTROL WITH MOTION SENSOR

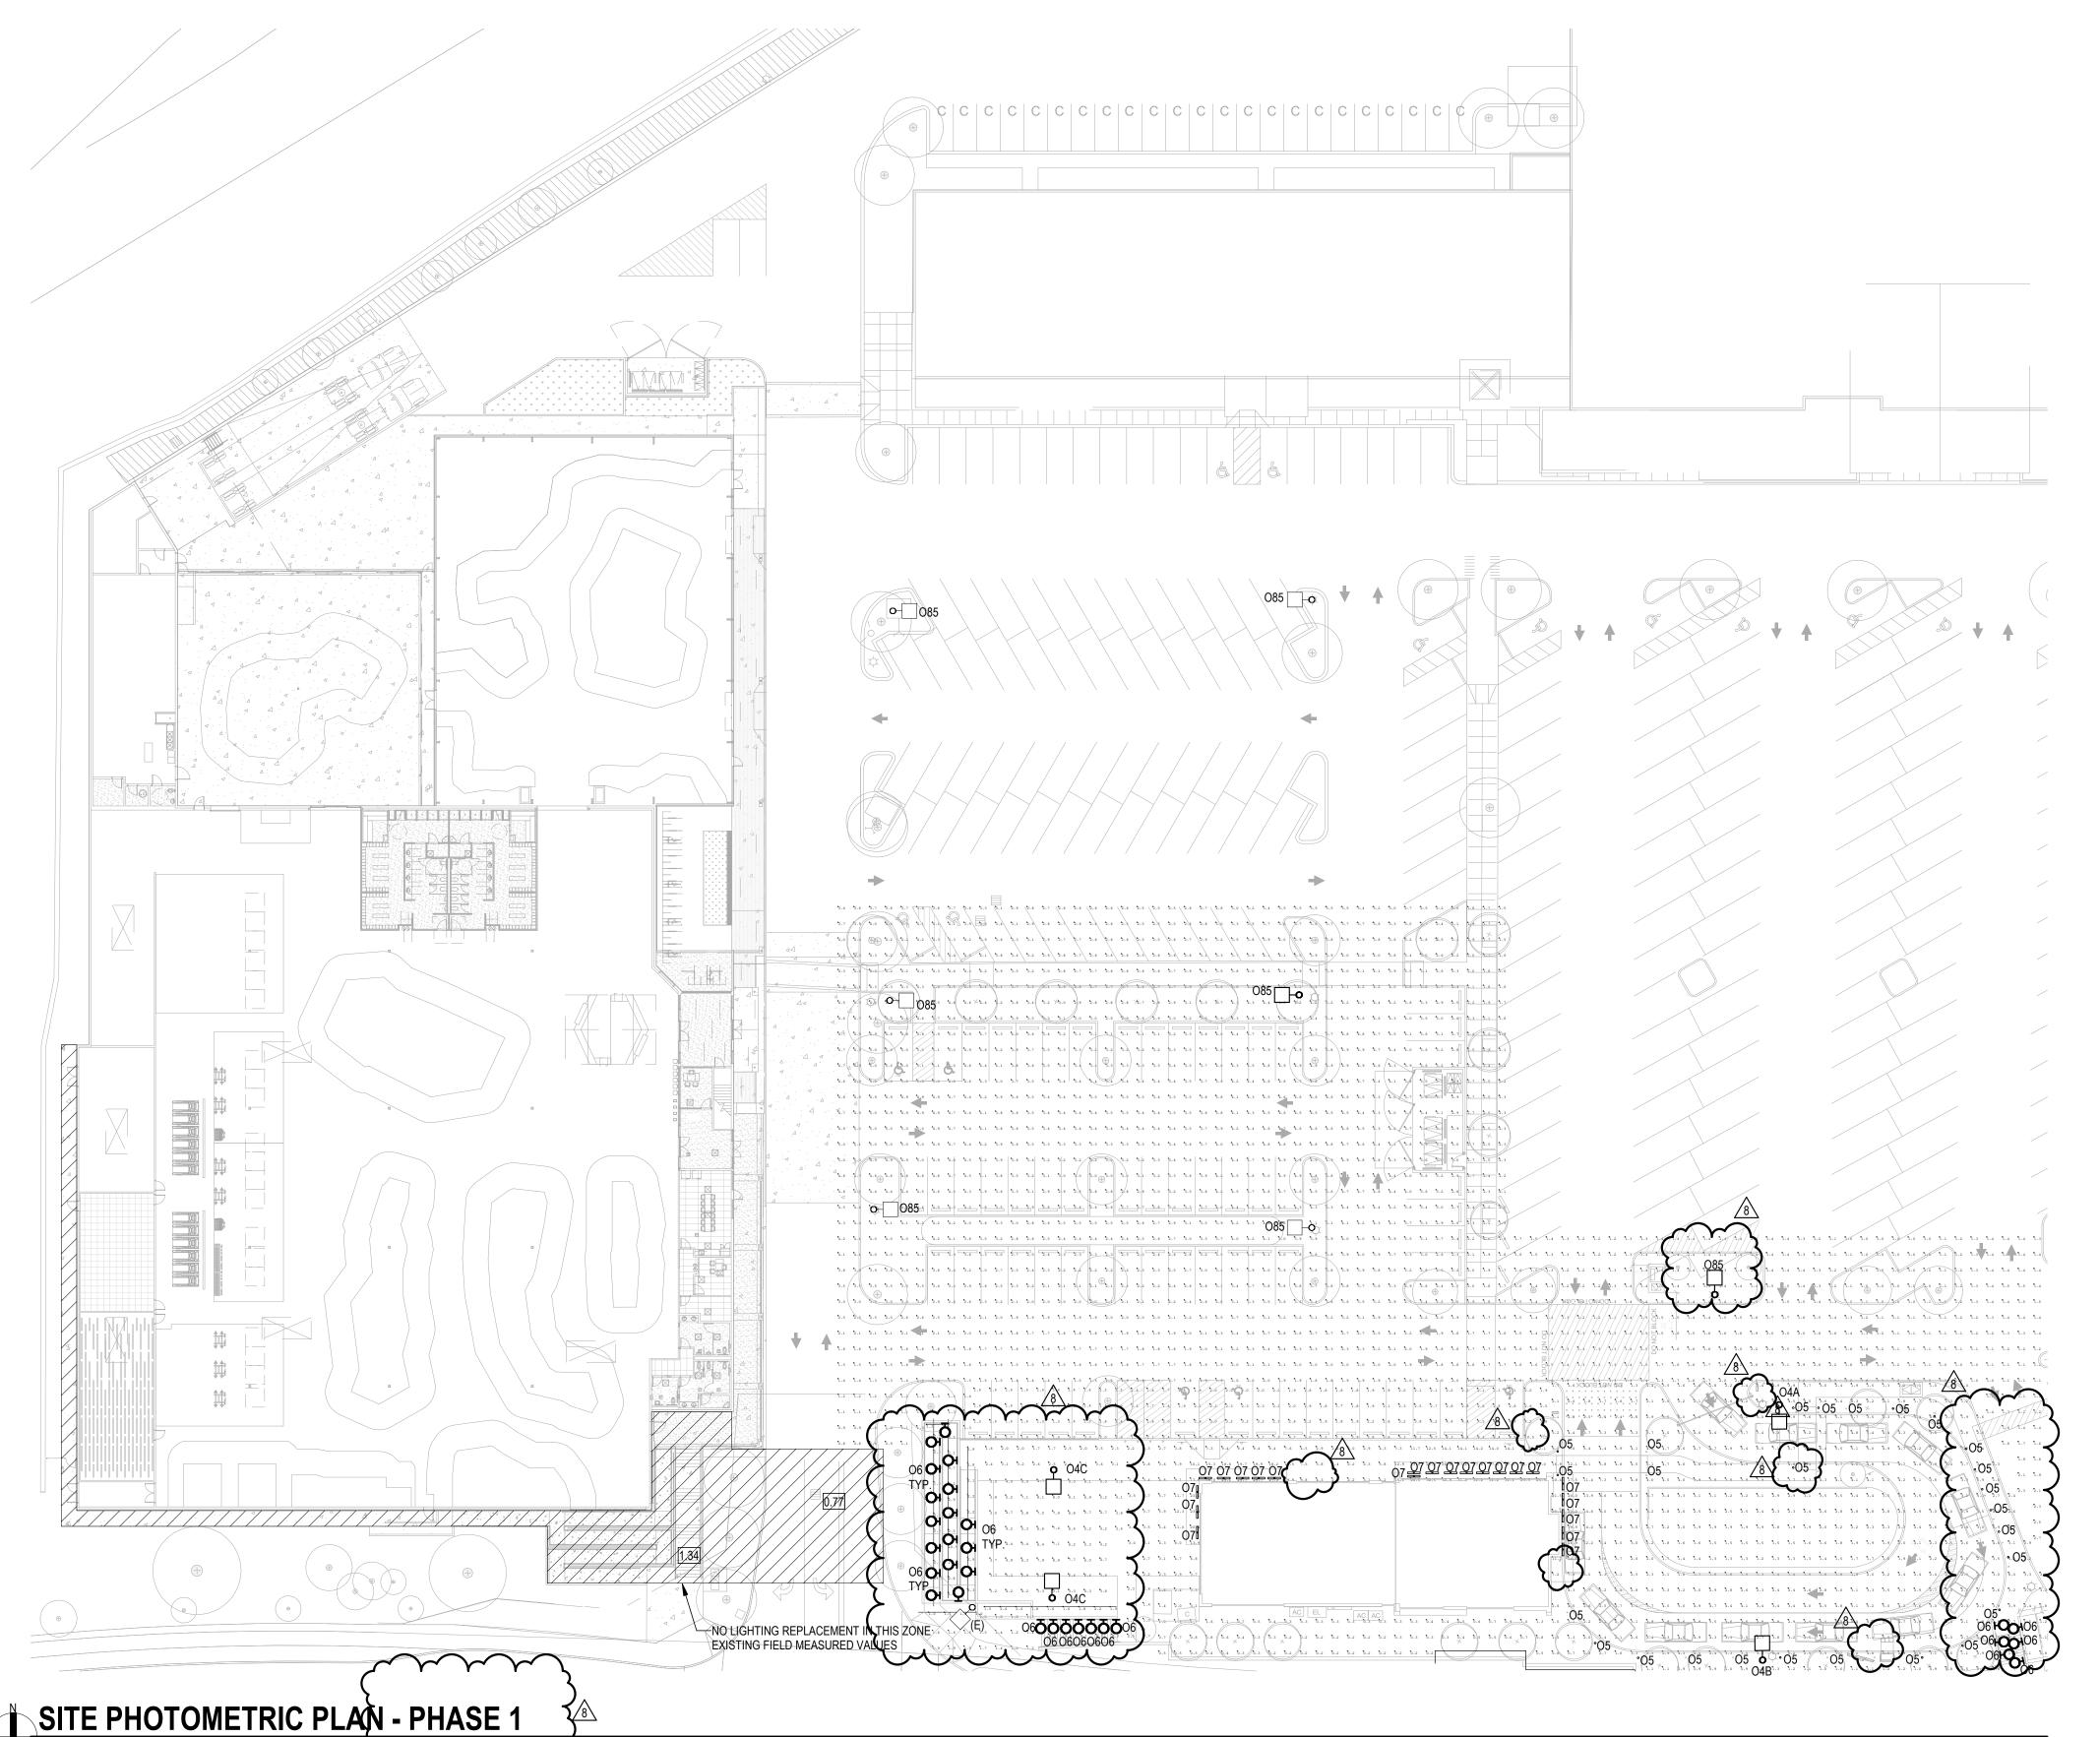

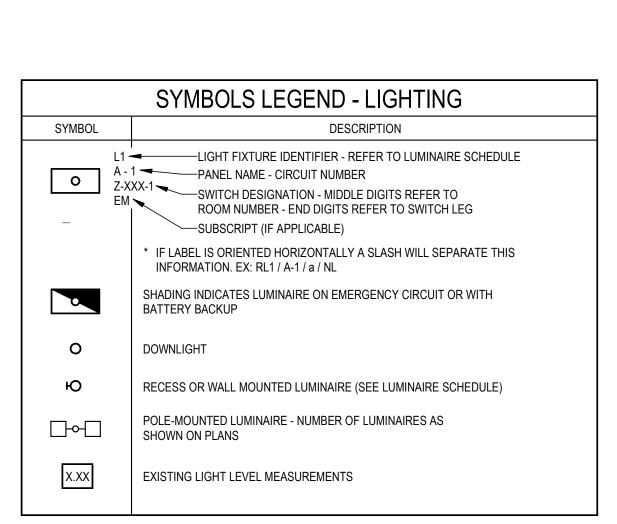

## SHEET NOTES

- A. ALL EXISTING LIGHT LEVEL MEASUREMENTS IN FOOT CANDLES UNLESS OTHERWISE NOTED.
- B. EXISTING LIGHT LEVEL MEASUREMENTS TAKEN WITH A GREENLEE 93-172 LIGHT METER AT 2'-6" ABOVE GRADE.
- C. EXISTING LIGHT LEVELS WERE TAKEN JANUARY 27TH, 2022. SITE CONDITIONS CONSISTED OF OVERCAST SKIES AND ALL TREES BARE FOR WINTER.
- D. LIGHTING CALCULATIONS DO NOT TAKE INTO ACCOUNT EXISTING LIGHT LEVEL READINGS.



Jaysinge

2410 N. Lombard Street Portland, OR 97217 503-546-1600 MattL@Baysinger.Partners

Baysinger Partners Architecture

Well-crafted simplicity.

GROUP

111 SW Fifth Ave, Ste 3210
Portland, Oregon 97204



PETERKORT MANAGEMENT CO.

TOWN SQUARE ROCK GYM

Issued / Revised
Revision 8 8 10/19/2023

PK 21056

Original Issue: 07.01.2022
Drawn/Checked By: LR / CL


© 2022 Baysinger Partners Architecture

PHOTOMETRIC -PLAN - PHASE 1

E1.01

DESIGN REVIEW

LUMINAIRE SCHEDULE													
FIXTURE TYPE	DESCRIPTION	MOUNTING	G CCT / CRI	INPUT WATTS (W)	LUMEN OUTPUT	EFFICACY (LUMENS / WATTS)	BALLAST / TRANSFORMER / DRIVER	VOLTAGE	LENS / REFLECTOR / BEAM	HOUSING	TRIM / FLANGE / BAFFLE / FINISH	MANUFACTURER / CATALOG #	REMARKS / ACCESSORIES/ OPTIONS
							EXTERIOR LIGHTING	G					
<b>O</b> 4	TYPE IV DISTRIBUTION AREA POLE LED LUMINAIRE	20' POLE	4000K 70CRI	100	12,000	120	0-10V DIMMING	UNV	CLEAR	ALUMIN	BY ARCHITECT	HUBBELL OUTDOOR LIGHTING RAR1 SERIES	WIRELESS CONTROL WITH MOTION
O4A	SAME AS TYPE O4 EXCEPT WITH TYPE 3 DISTRIBUTION AND HIGHER LUME	20' POLE	4000K 70CRI	160	21,488	120	0-10V DIMMING	UNV	CLEAR	ALUMIN	BY ARCHITECT	HUBBELL OUTDOOR LIGHTING RAR2 SERIES	WIRELESS CONTROL WITH MOTION
O4B	SAME AS TYPE O4 EXCEPT WITH TYPE 2 DISTRIBUTION AND HIGHER LUME	20' POLE	4000K 70CRI	133	12,000	120	0-10V DIMMING	UNV	CLEAR	ALUMIN	BY ABCHITECT	HUBBELLOUTDOOR LIGHTING RARE SERIES	WIRELES'S CONTROL WITH MOTION
O5	BOLLARD LED LUMINAIRE	39" POLE	3000K 80CRI	3	136	45	INTEGRAL 12V DRIVER	UNV	CLEAR	ALUMIN	BY ARCHITECT	BEGA BOLLARD SERIES	WIRELESS CONTROL WITH MOTION
O6	IN WALL STEPLIGHT LED LUMINAIRE	WALL	3000K 80CRI	3	274	91	0-10V DIMMING	UNV	CLEAR	ALUMIN	BY ARCHITECT	BEGA RECESSED WALL LUMINAIRE SERIES	WIRELESS CONTROL WITH MOTION
07	4'-0" WET LINEAR LED STRIP LUMINAIRE	SURFACE	3000K 96CRI	35	3,000	85	0-10V DIMMING	24VDC	CLEAR	ALUMIN	BY RCHITECT	OPTIC ARTS BY LUMINII LINELED X18X2-WET-T	WIRELESS CONTROL WITH MOTION
O83	TYPE IV DISTRIBUTION AREA POLE LED LUMINAIRE	30' POLE	4000K 80CRI	343	42,341	343	0-10V DIMMING	UNV	CLEAR	ALUMINU M	BY (RCHITECT	LITHONIA D SERIES SIZE 2, TYPE 3 DSX2 LED-P6-40K-T3M-MVOLT-BPA-NLTAIR2-PIRH-DNAX	WIRELESS CONTROL WITH MOTION SENSOR
O85	TYPE V DISTRIBUTION AREA POLE LED LUMINAIRE	30' POLE	4000K 80CRI	343	42,341	343	0-10V DIMMING	UNV	CLEAR	ALUMINU M	BY ARCHITECT	LITHONIA D SERIES SIZE 2, TYPE 5 DSX2 LED-P6-40K-T5M-MVOLT-RPA-NLTAIR2-PIRH-DNAXI	WIRELESS CONTROL WITH MOTION SENSOR

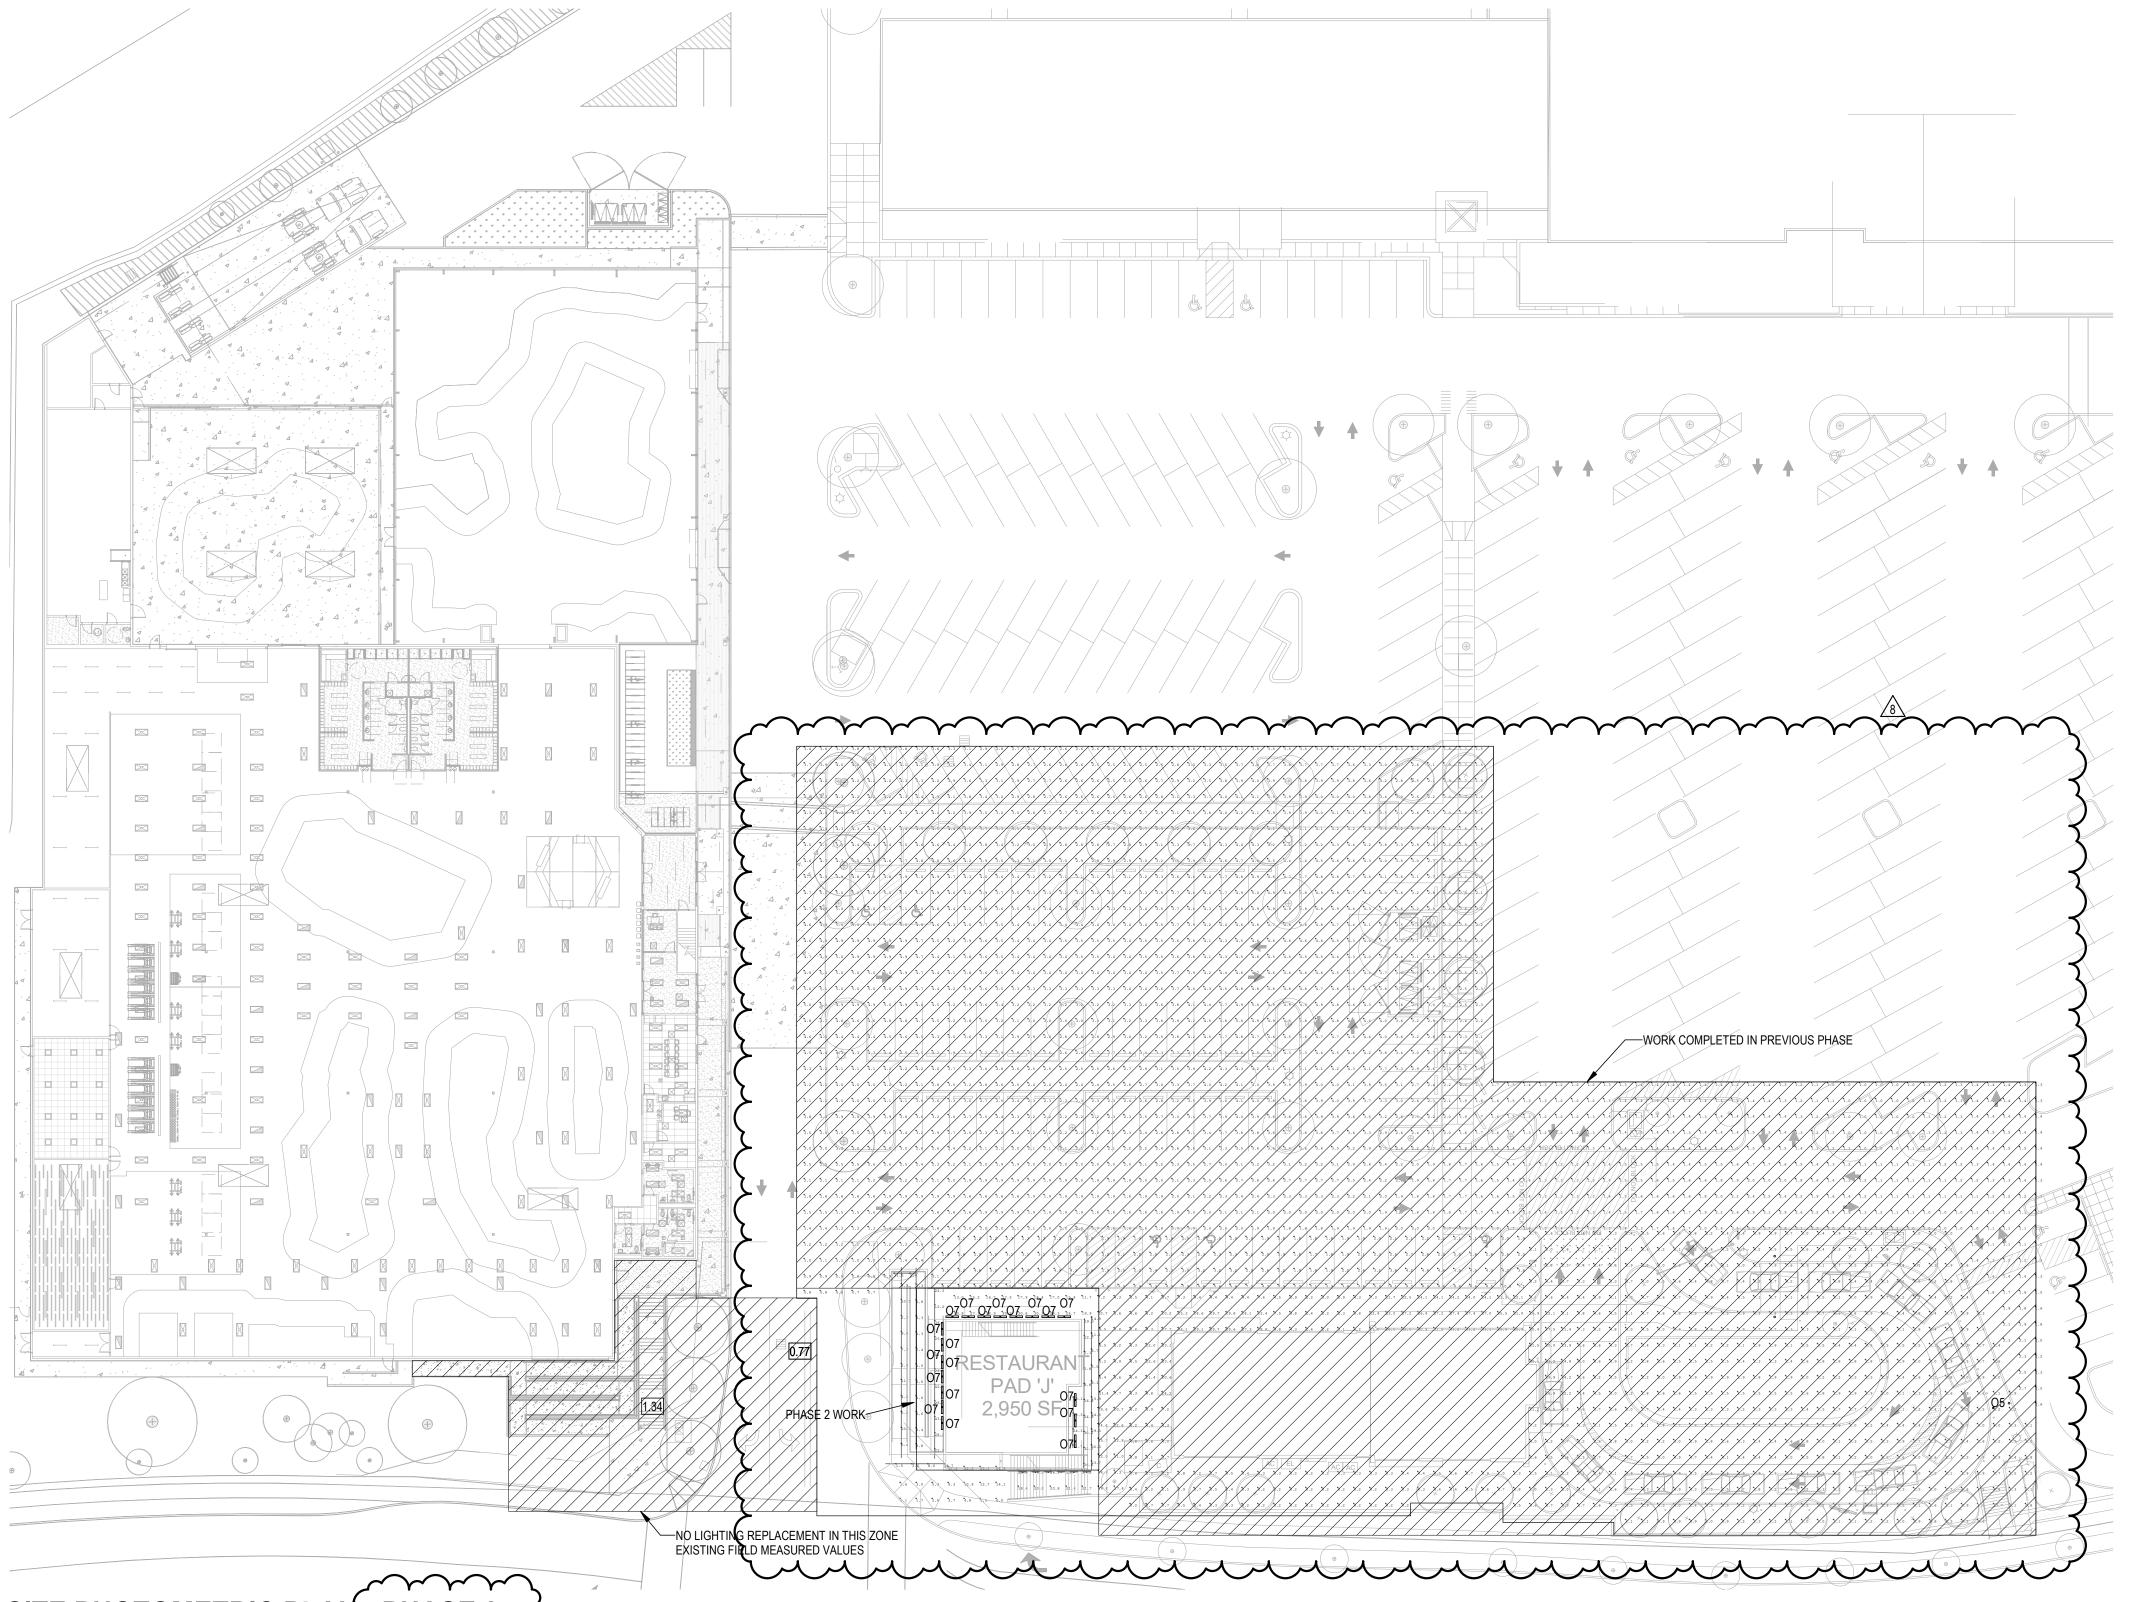



Baysinger Partners Architecture 2410 N. Lombard Street Portland, OR 97217

503-546-1600 MattL@Baysinger.Partners



Well-crafted simplicity.

GROUP

111 SW Fifth Ave, Ste 3210 Portland, Oregon 97204



**PETERKORT** MANAGEMENT CO.

## **TOWN SQUARE STARBUCKS** AND PAD

Planning Comments 7 01/13/2023

Revision 8 8 10/19/2023

PK 21052

Original Issue: 07.01.2022

PHOTOMETRIC -PLAN - PHASE 2

SHEET NOTES

SYMBOL

0

A. ALL EXISTING LIGHT LEVEL MEASUREMENTS IN FOOT CANDLES UNLESS OTHERWISE NOTED.

EXISTING LIGHT LEVEL MEASUREMENTS

B. EXISTING LIGHT LEVEL MEASUREMENTS TAKEN WITH A GREENLEE 93-172 LIGHT METER AT 2'-6" ABOVE GRADE.

C. EXISTING LIGHT LEVELS WERE TAKEN JANUARY 27TH, 2022. SITE CONDITIONS CONSISTED OF OVERCAST SKIES AND ALL TREES BARE FOR WINTER.

SYMBOLS LEGEND - LIGHTING

ROOM NUMBER - END DIGITS REFER TO SWITCH LEG

\* IF LABEL IS ORIENTED HORIZONTALLY A SLASH WILL SEPARATE THIS INFORMATION. EX: RL1 / A-1 / a / NL

SHADING INDICATES LUMINAIRE ON EMERGENCY CIRCUIT OR WITH

RECESS OR WALL MOUNTED LUMINAIRE (SEE LUMINAIRE SCHEDULE)

POLE-MOUNTED LUMINAIRE - NUMBER OF LUMINAIRES AS

A - 1 PANEL NAME - CIRCUIT NUMBER

BATTERY BACKUP

LINEAR LUMINARE

SHOWN ON PLANS

BOLLARD

O Z-XXX-1 SWITCH DESIGNATION - MIDDLE DIGITS REFER TO

DESCRIPTION

D. LIGHTING CALCULATIONS DO NOT TAKE INTO ACCOUNT EXISTING LIGHT LEVEL READINGS.

SITE PHOTOMETRIC PLAN-PHASE 2